
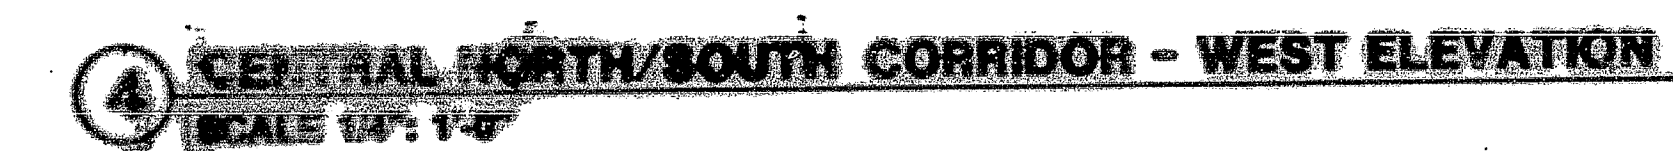
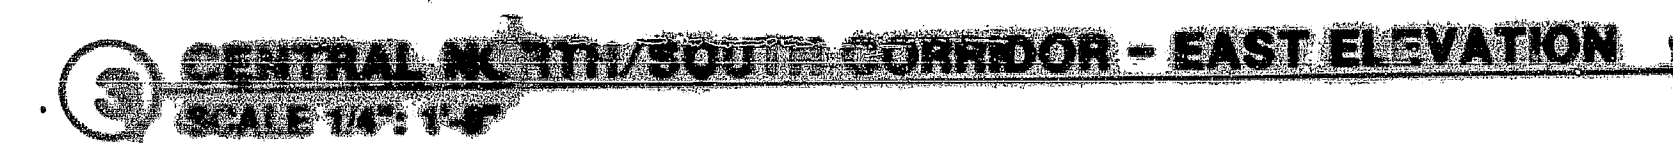


TAA # 941154
5/1/95

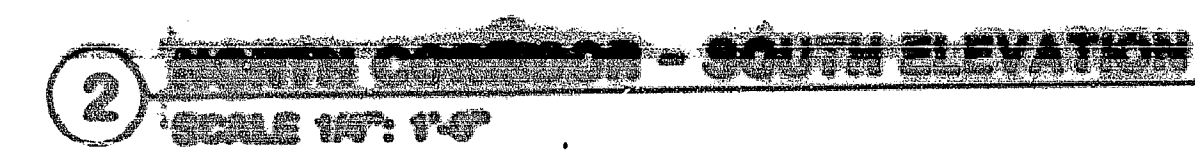

No.	Revision Date	Issued Record
		O M S CM
⚠	11.95 REMOVED AS PER TENANT REQUEST	
	5.1.95 "AS-BUILT"	

INTERIOR ELEVATIONS

T.A.A. #941154

Date AS NOTED	Drawn By CL
Project No. 94169	Date 6/26/04

